


GVB IFB 2020-001
REFERENCE 1

Chalan San Vitores Median Lighting Power Plan As-Builts

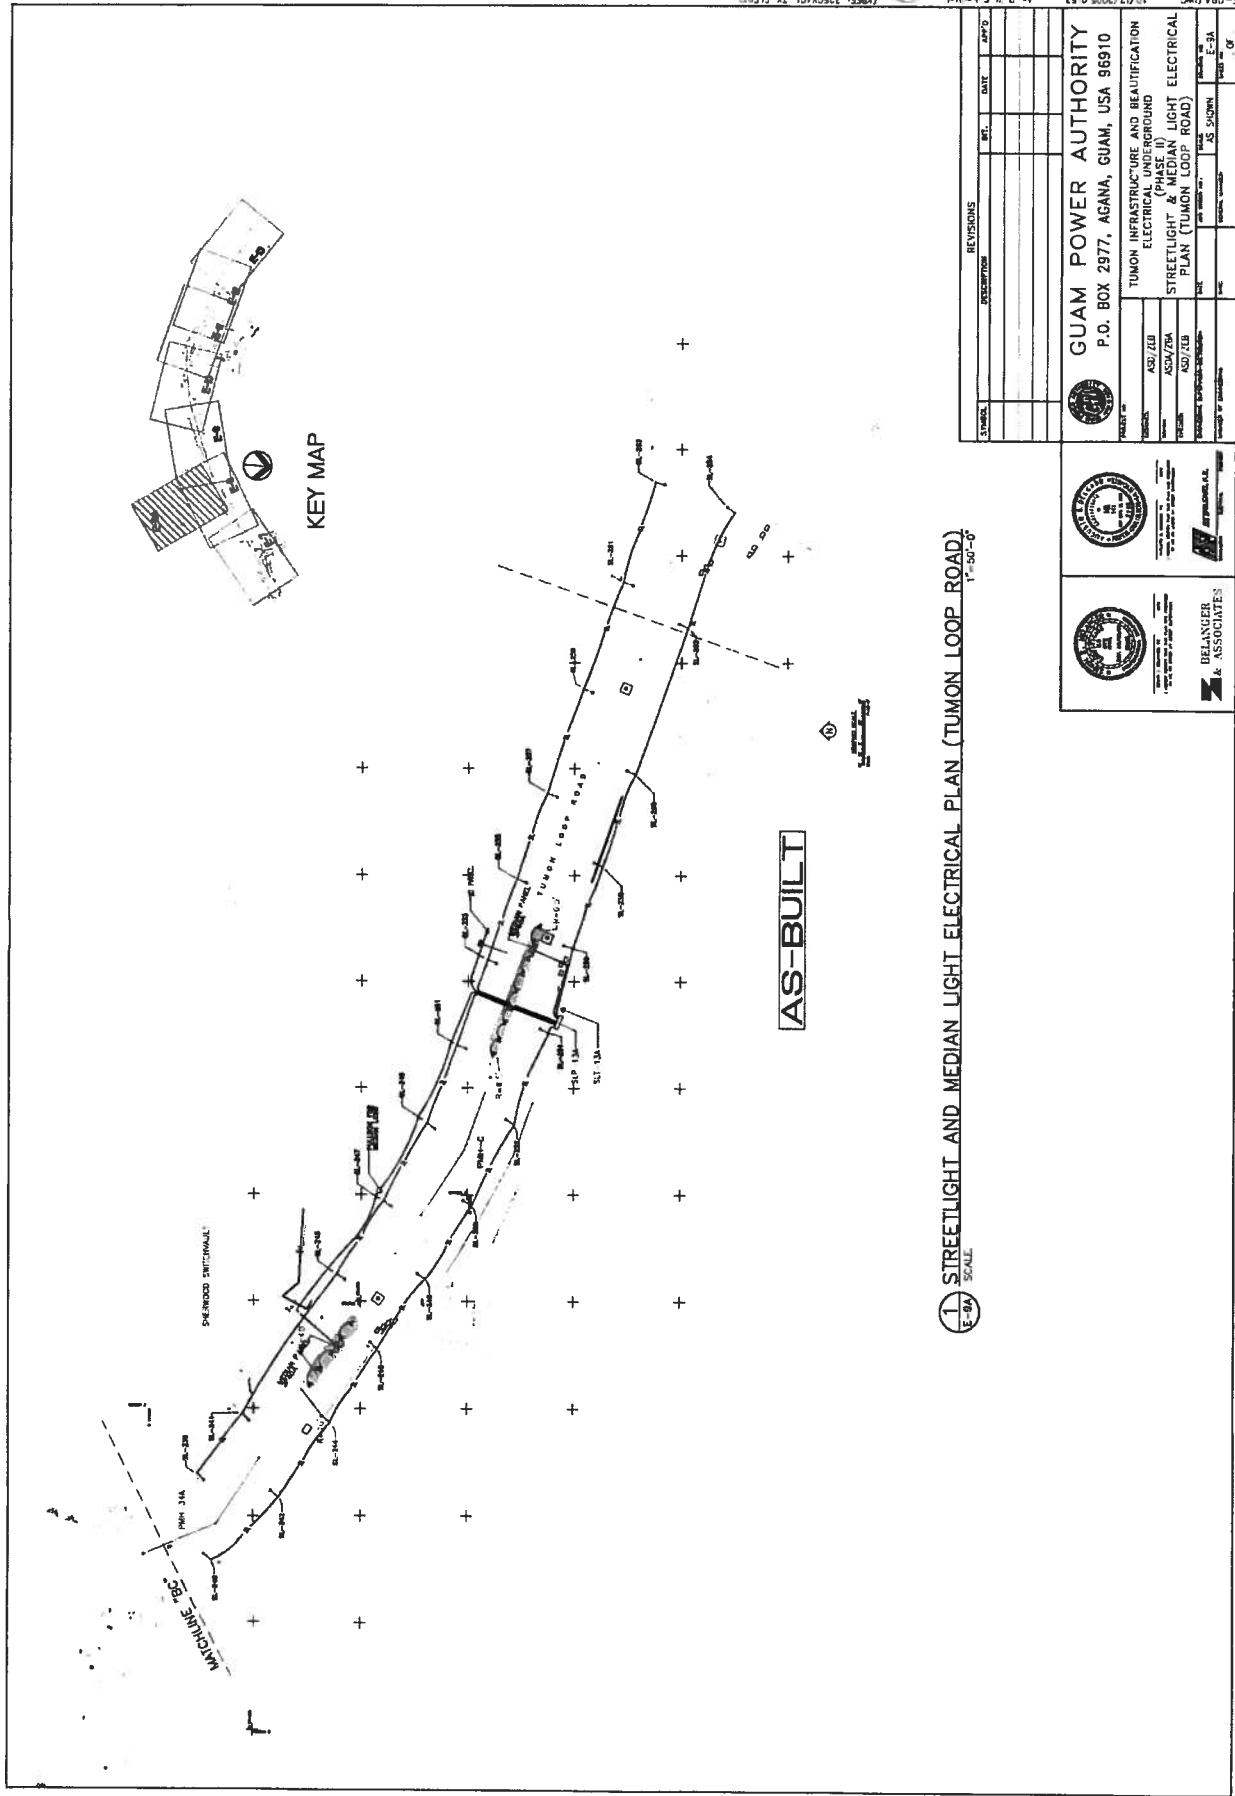

REVISIONS		DATE	APPROVED
SYMBOL	DESCRIPTION	DATE	APPROVED

GUAM POWER AUTHORITY
 P.O. BOX 2977, AGANA, GUAM, USA 96910

TUMON INFRASTRUCTURE AND BEAUTIFICATION
 ELECTRICAL UNDERGROUND
 STREETLIGHT & MEDIAN LIGHT ELECTRICAL
 PLAN (TUMON LOOP ROAD)



BELANGER & ASSOCIATES
 ENGINEERS, P.E.
 1000 N. NIMITZ BLVD., SUITE 200
 AGANA, GUAM 96910


BELANGER & ASSOCIATES
 ENGINEERS, P.E.
 1000 N. NIMITZ BLVD., SUITE 200
 AGANA, GUAM 96910

PROJECT NO.	AS-07
DATE	AS-07
SCALE	AS SHOWN
DESIGNED BY	AS-07
CHECKED BY	AS-07
APPROVED BY	AS-07





BELANGER & ASSOCIATES
 ENGINEERS, P.E.
 1000 N. NIMITZ BLVD., SUITE 200
 AGANA, GUAM 96910

BELANGER & ASSOCIATES
 ENGINEERS, P.E.
 1000 N. NIMITZ BLVD., SUITE 200
 AGANA, GUAM 96910

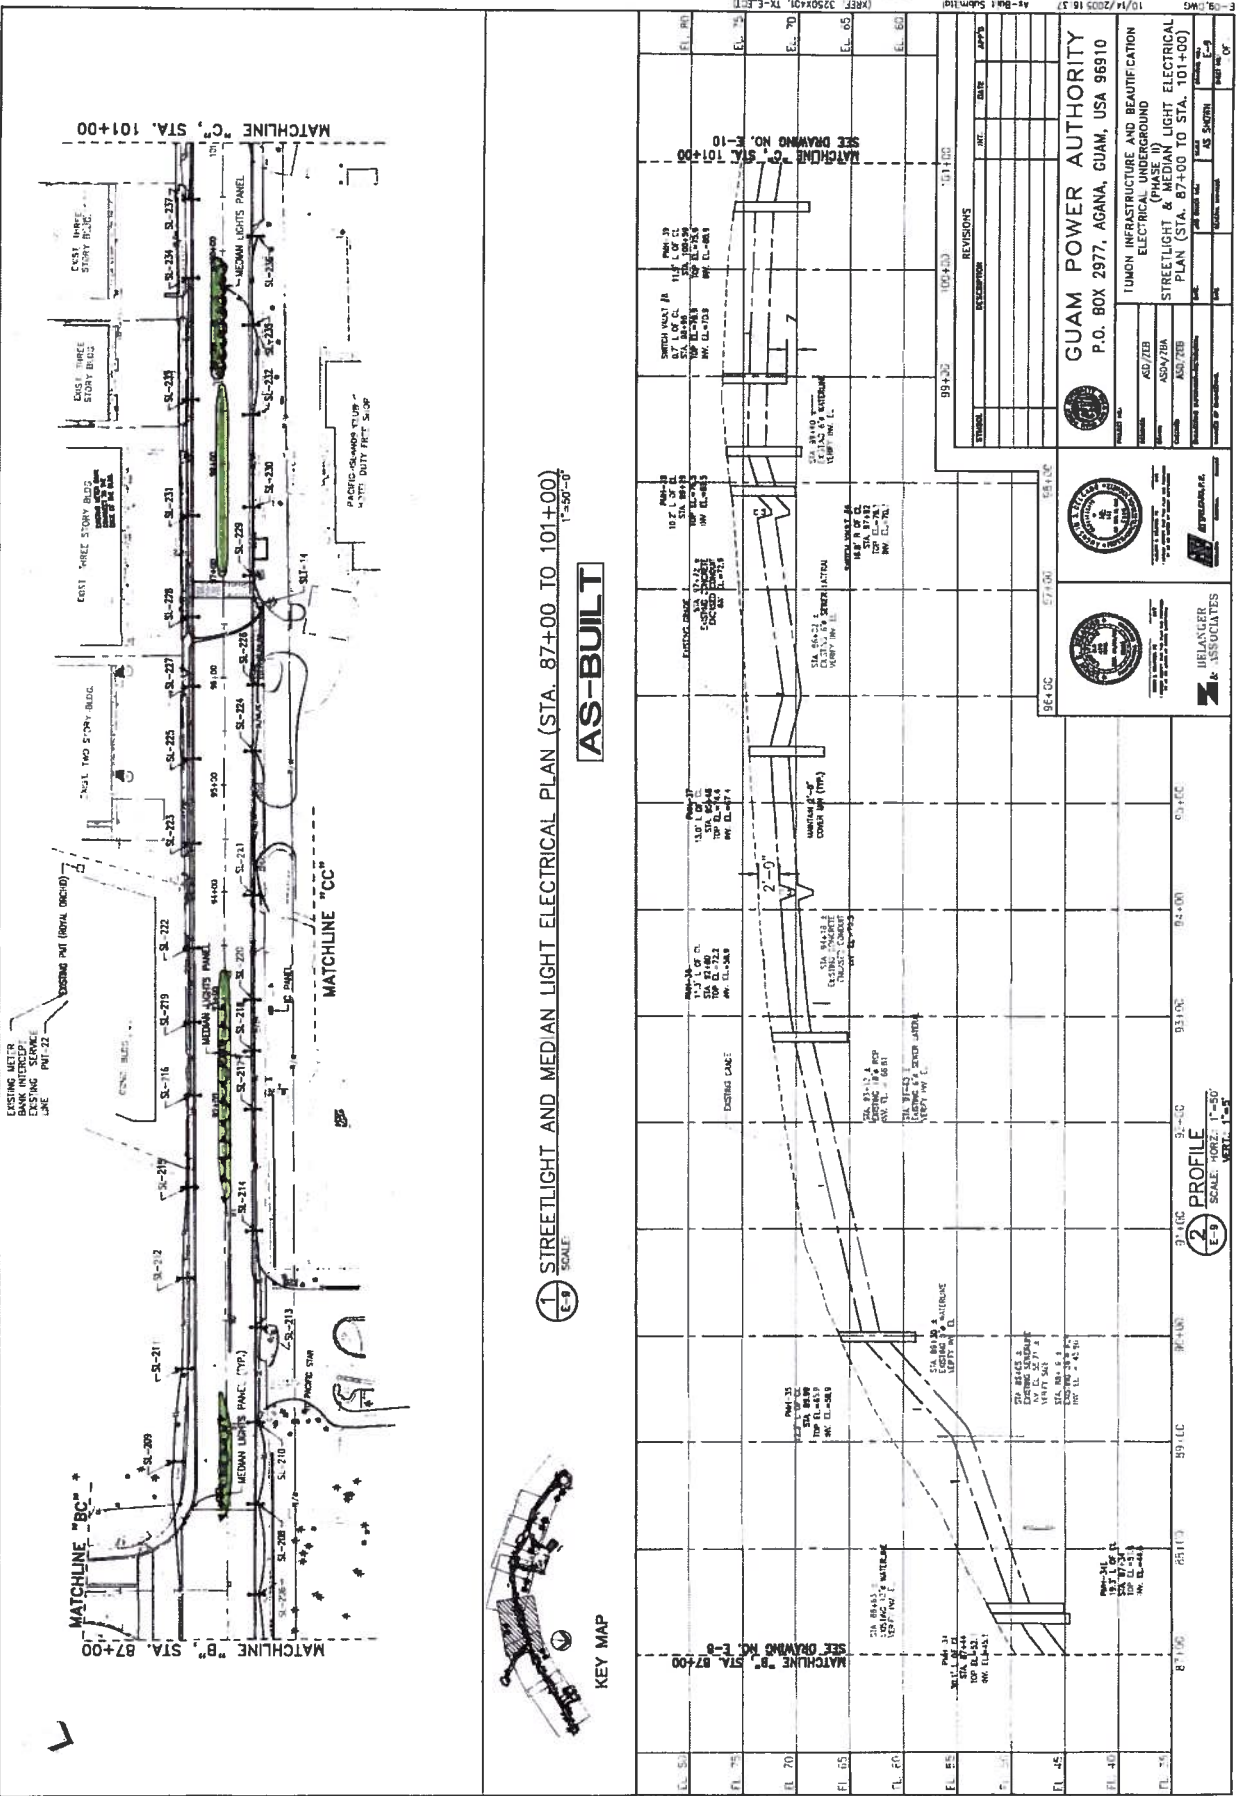




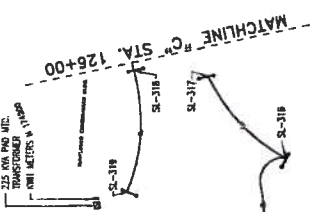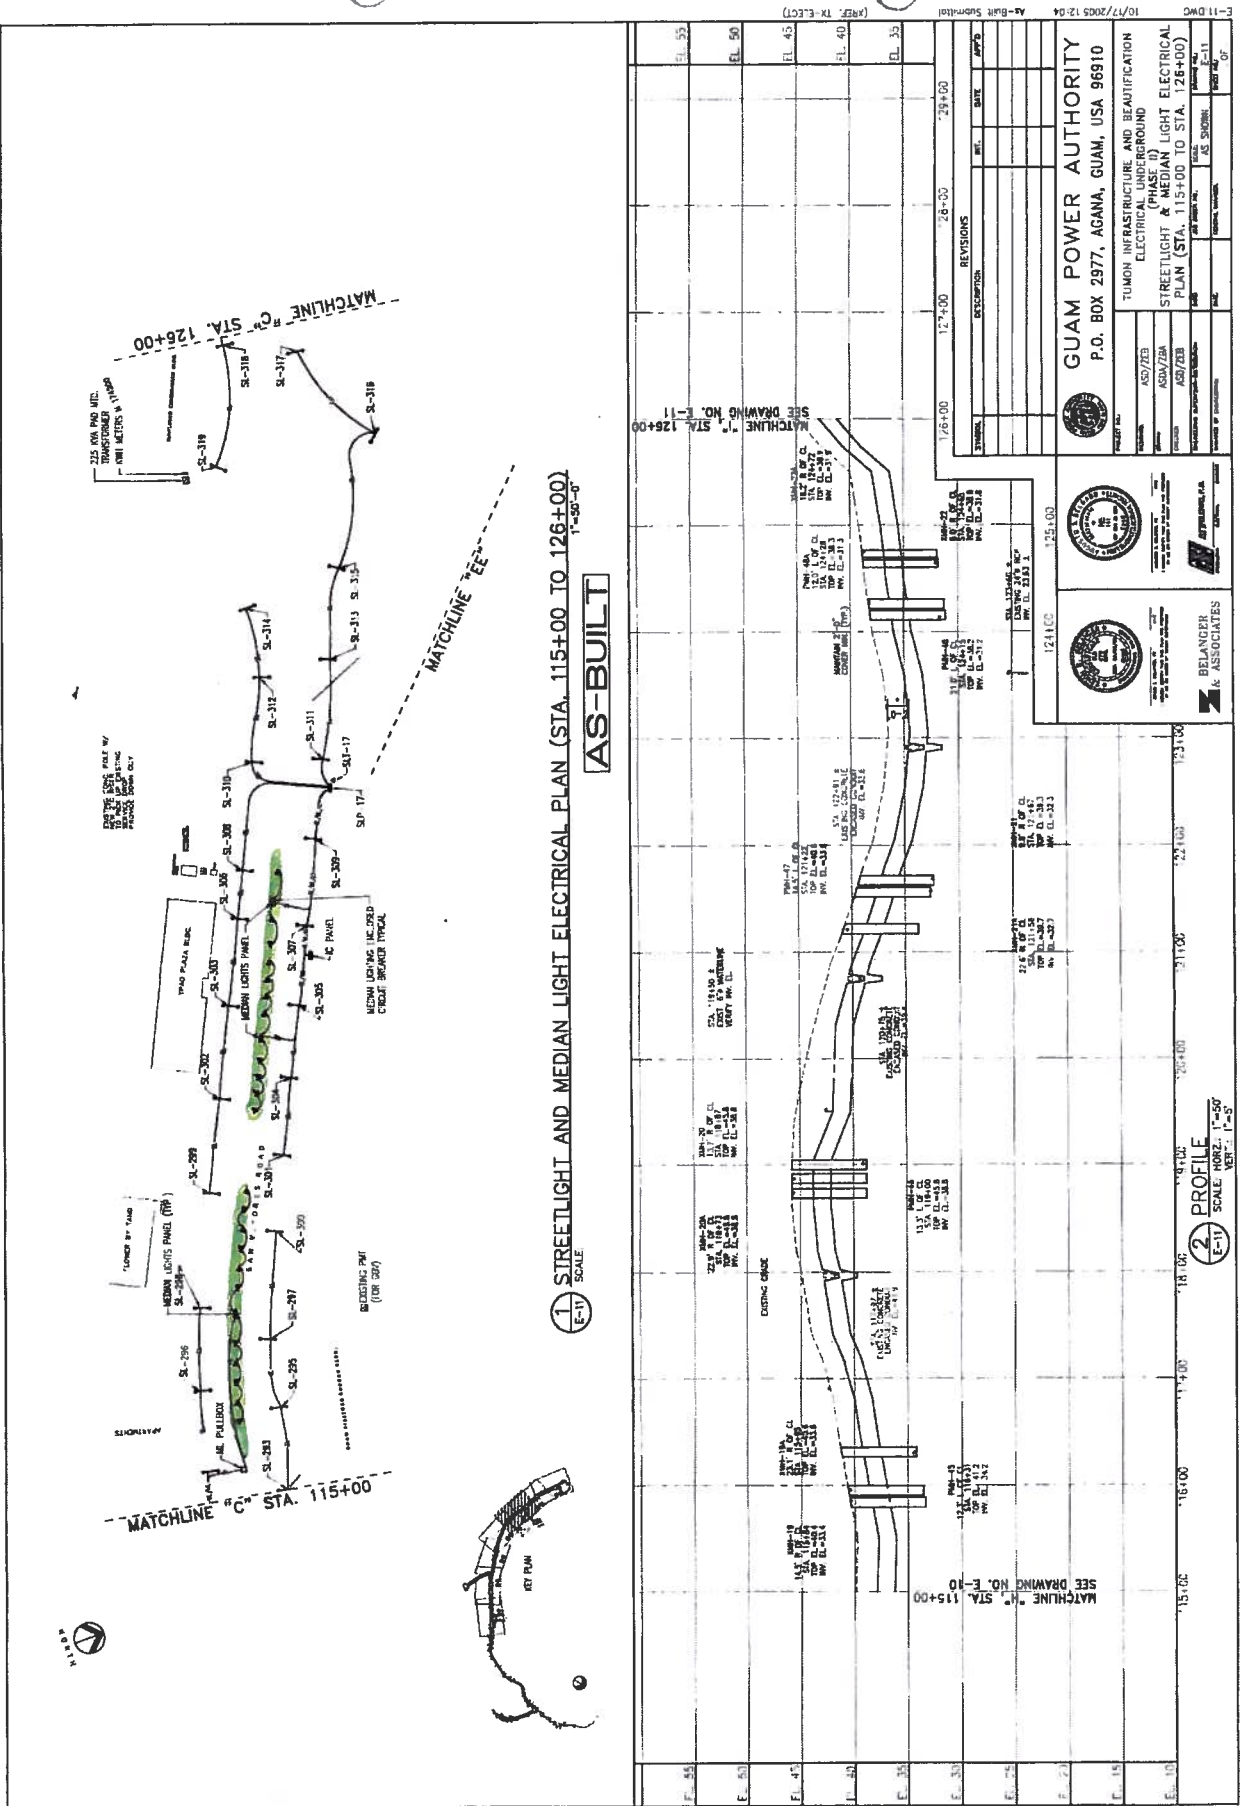

1 STREETLIGHT AND MEDIAN LIGHT ELECTRICAL PLAN (STA. 115+00 TO 126+00)
 E-11 SCALE: 1"=50'-0"

AS-BUILT

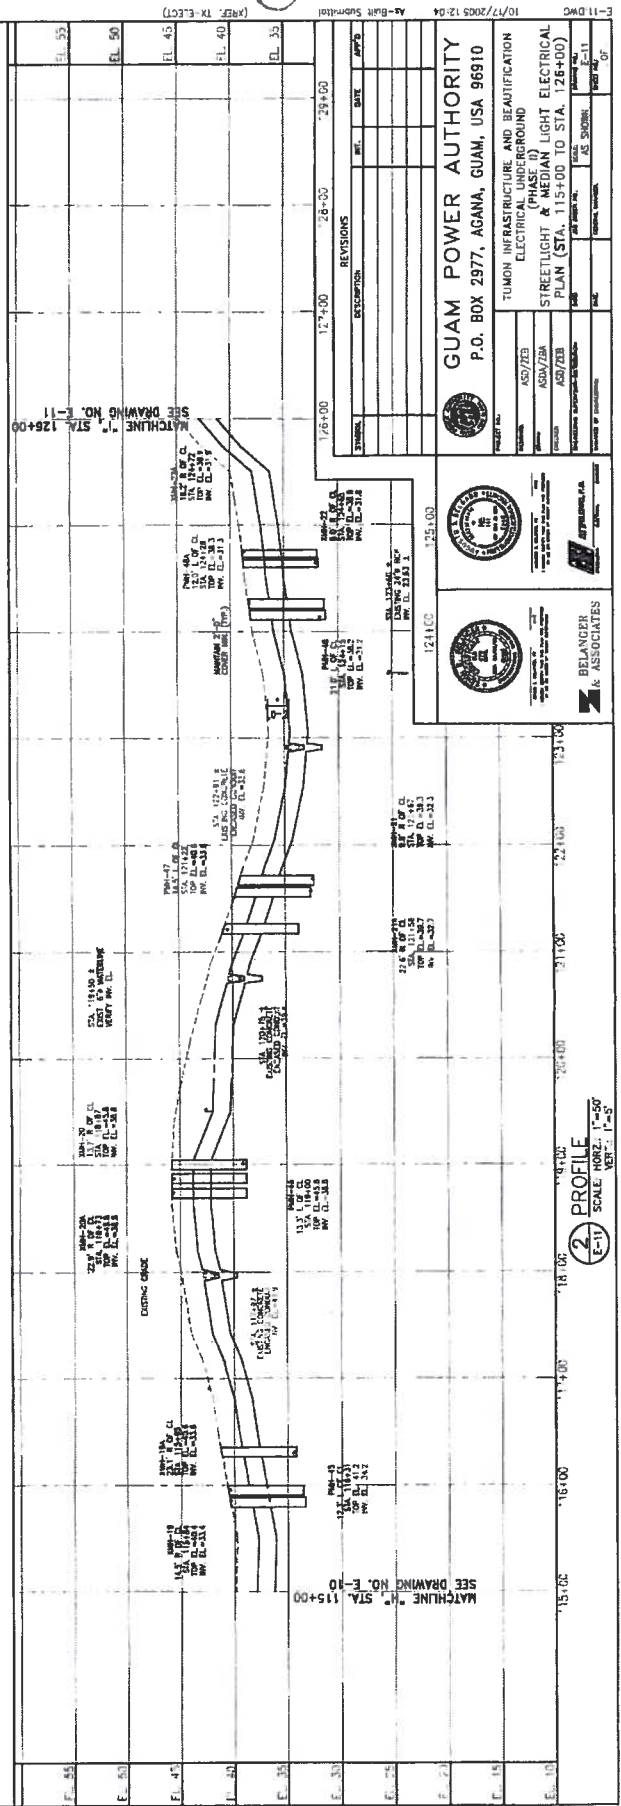


SEE DRAWING NO. E-10
 MATCHLINE "A" STA. 115+00

MATCHLINE "B" STA. 126+00
 DRAWING NO. E-11


REVISIONS	
NO.	DESCRIPTION
1	ISSUED FOR CONSTRUCTION

PROJECT NO.	10/17/2005 12.04
PROJECT NAME	GUAM POWER AUTHORITY
PROJECT LOCATION	P.O. BOX 2977, AGANA, GUAM, USA 96910
DESIGNED BY	ASD/ZEB
CHECKED BY	ASD/ZEB
APPROVED BY	ASD/ZEB
DATE	10/17/2005

TUMON INFRASTRUCTURE AND BEAUTIFICATION PROJECT	
ELECTRICITY AND LIGHTING	
STREETLIGHT & MEDIAN LIGHT ELECTRICAL PLAN (STA. 115+00 TO STA. 126+00)	
SCALE	1"=50'-0"
DATE	10/17/2005

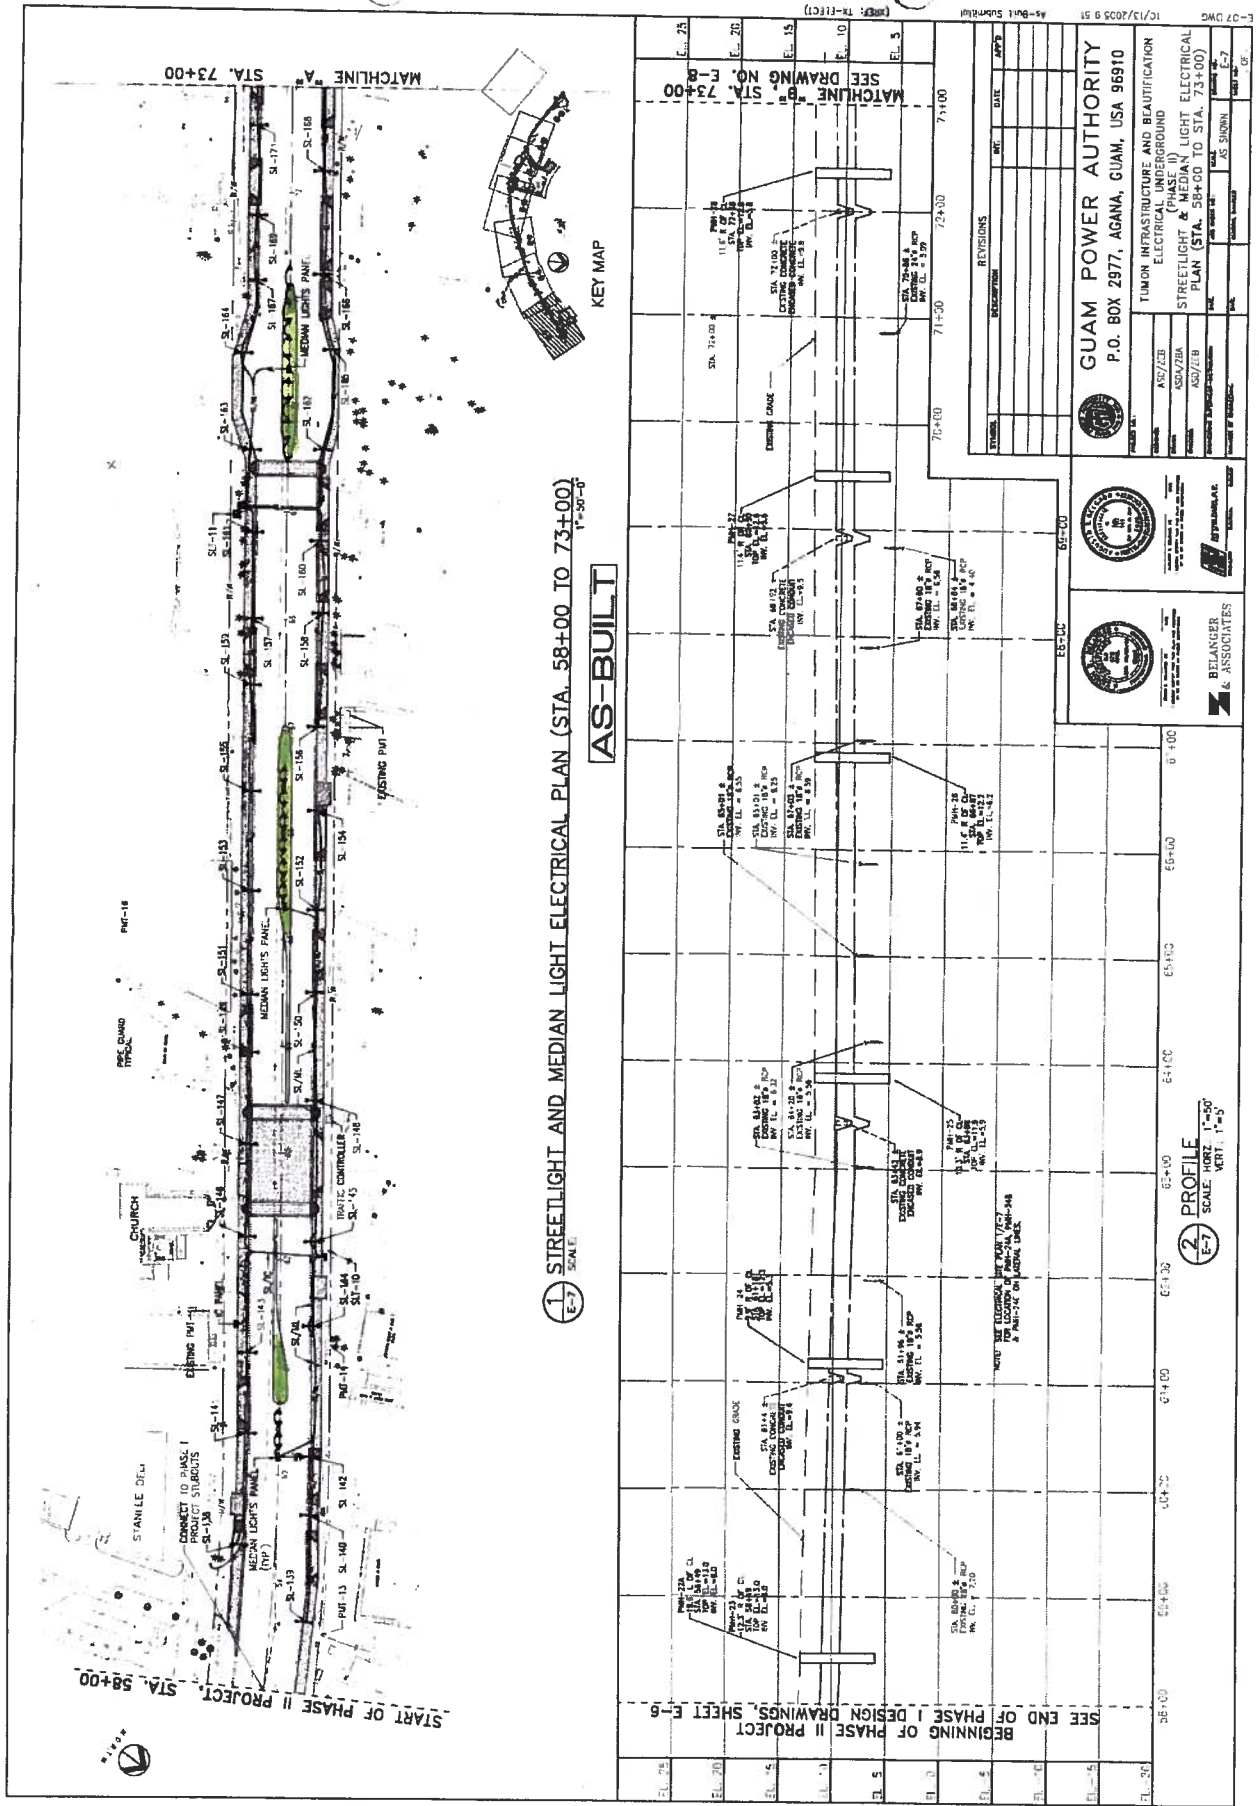

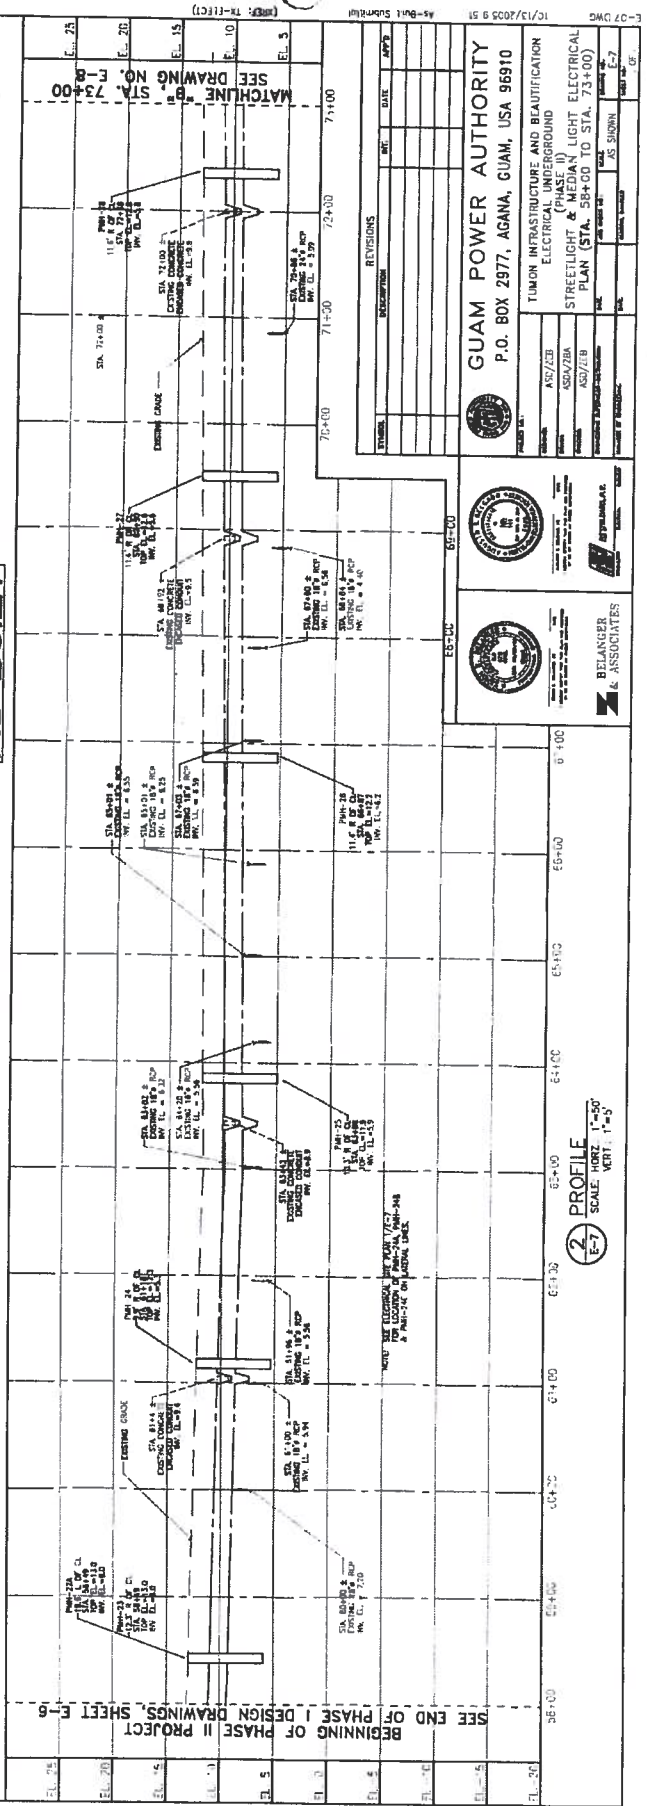

AS-BUILT
 STREETLIGHT AND MEDIAN LIGHT ELECTRICAL PLAN (STA. 58+00 TO 73+00)
 SCALE: 1"=50'-0"




2
 PROFILE
 SCALE: 1"=50'
 VERT. 1"=5'




REVISIONS	DATE	BY	APP'D

GUAM POWER AUTHORITY
 P.O. BOX 2977, AGANA, GUAM, USA 96910
 TUNON INFRASTRUCTURE AND BEAUTIFICATION
 ELECTRIFICATION PROGRAM
 STREETLIGHT & MEDIAN LIGHT ELECTRICAL
 PLAN (STA. 58+00 TO STA. 73+00)


BELANGER & ASSOCIATES
 ENGINEERS
 1000 KAGAN DRIVE, SUITE 100
 TAILOR, GUAM 96910
 TEL: (671) 255-1234
 FAX: (671) 255-1235
 WWW: WWW.BELANGER-ASSOCIATES.COM

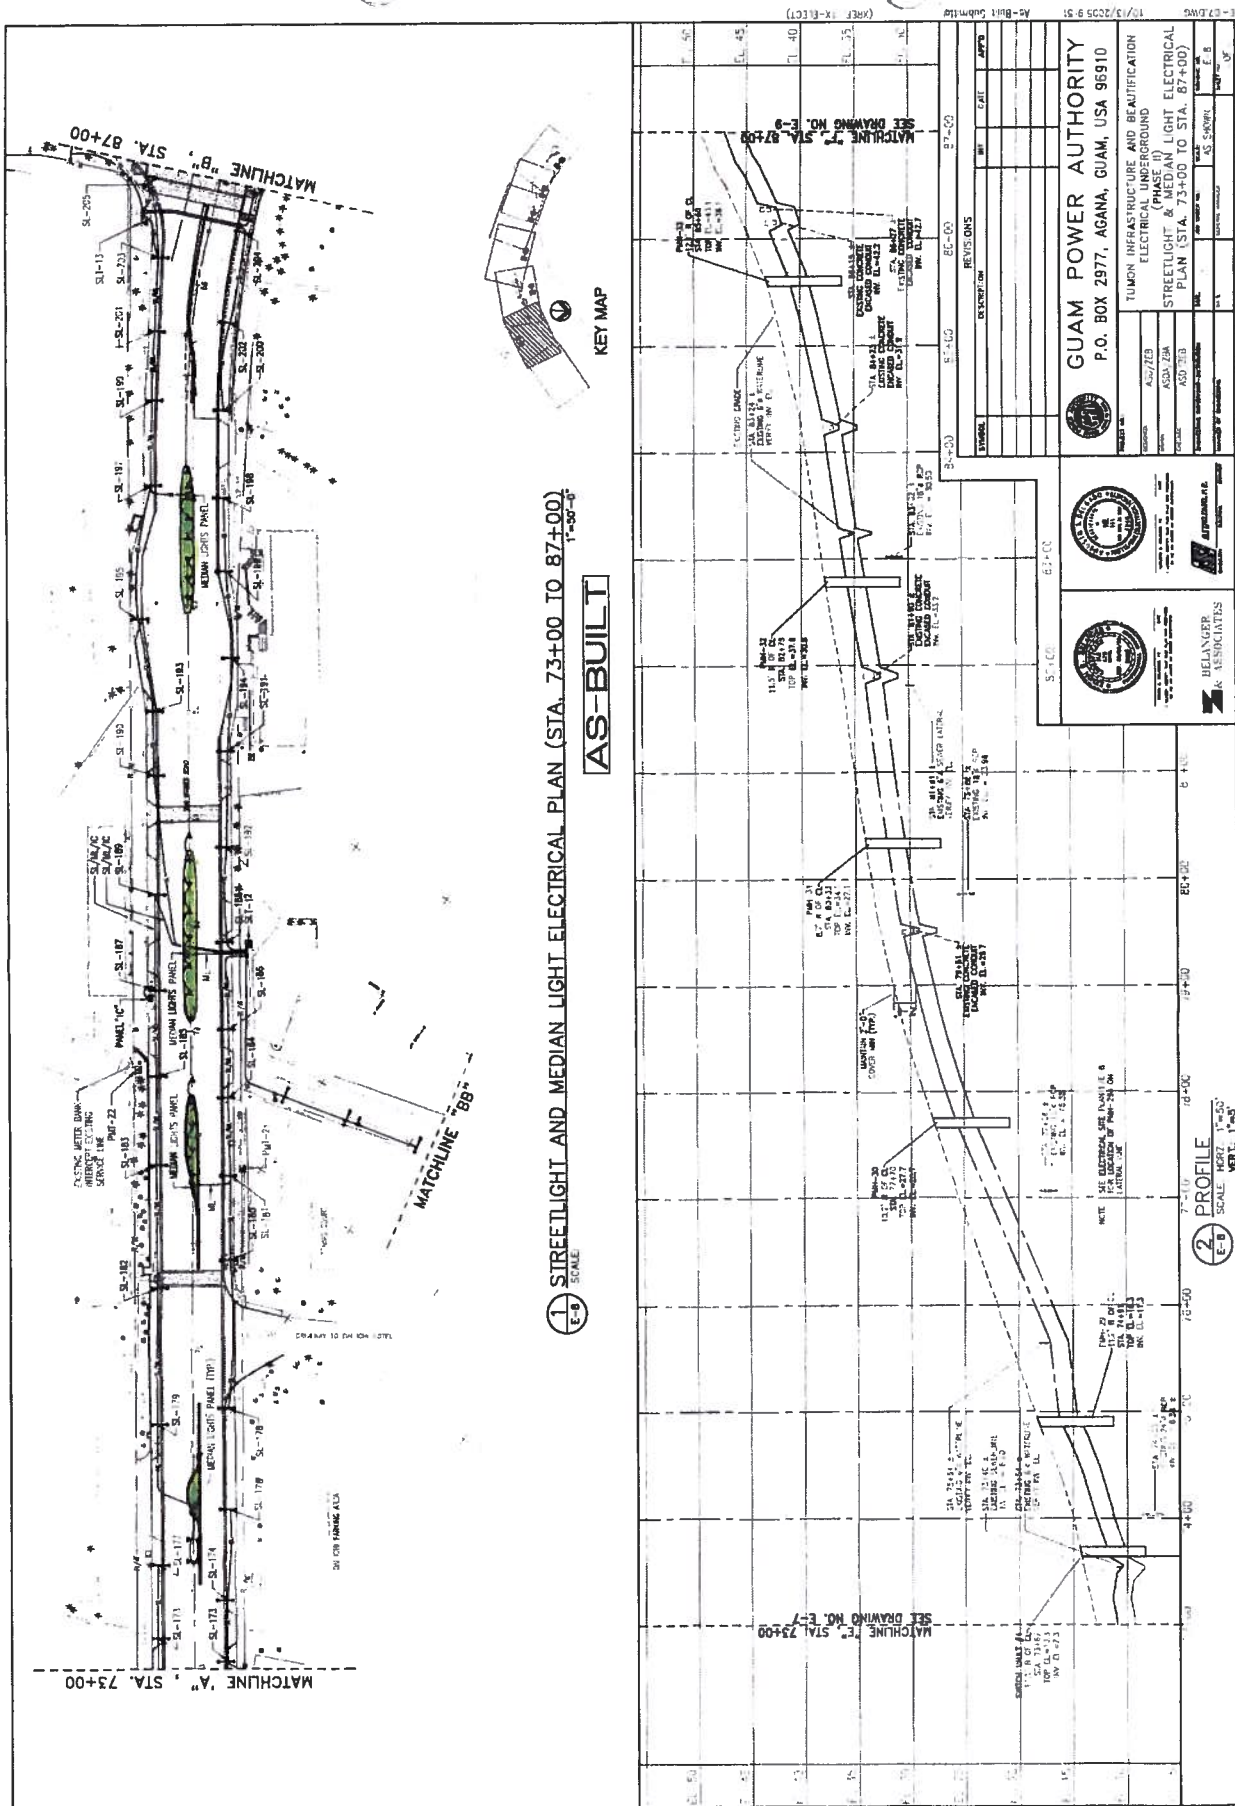


END OF PHASE II

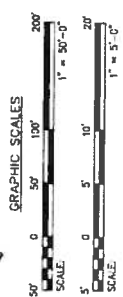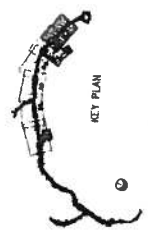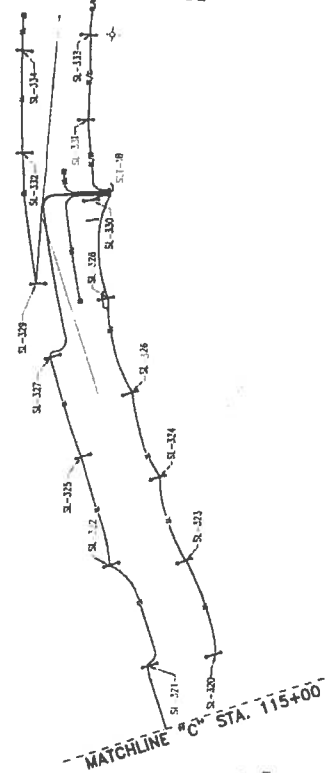

AS-BUILT

1 STREETLIGHT AND MEDIAN LIGHT ELECTRICAL PLAN (STA. 126+00 TO 133+00) 1"=50'-0"

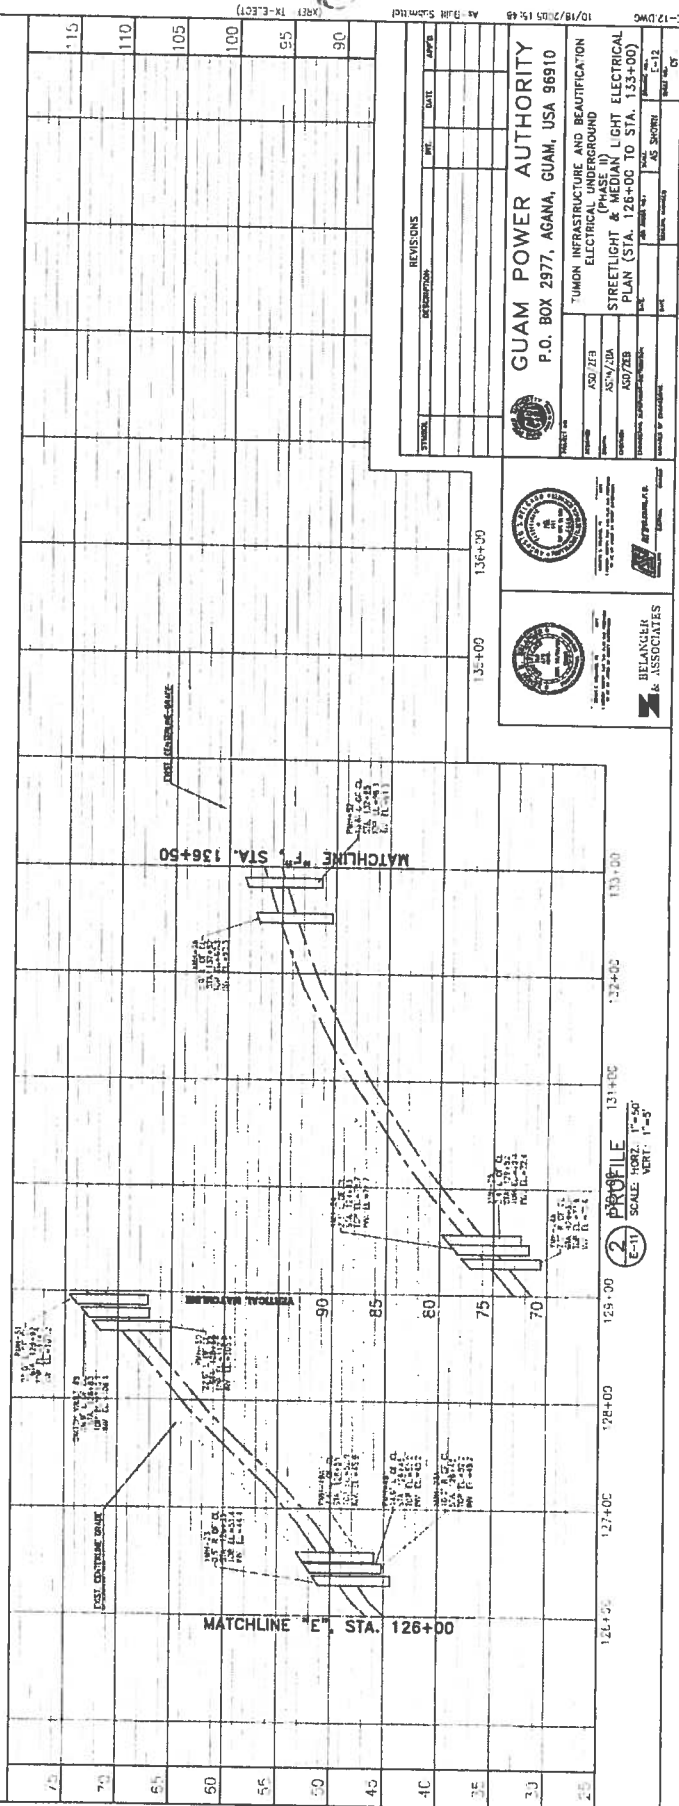

2 PROFILE E-11 SCALE: HORIZ. 1"=50' VERT. 1"=5'

GUAM POWER AUTHORITY
P.O. BOX 2977, AGANA, GUAM, USA 96910

GUAM INFRASTRUCTURE AND BEAUTIFICATION
STREETLIGHT & MEDIAN LIGHT ELECTRICAL
PLAN (STA. 126+00 TO STA. 133+00)

BELANGER & ASSOCIATES

STATION	DESCRIPTION	DATE	BY	CHKD
126+00	STREETLIGHT AND MEDIAN LIGHT ELECTRICAL PLAN	10/18/2015	15-48	